

Note: The Property Of This Drawing Is Vested In TARGET SES LTD And Must Not Be Copied Or Reproduced In Any Way Without Their Written Consen



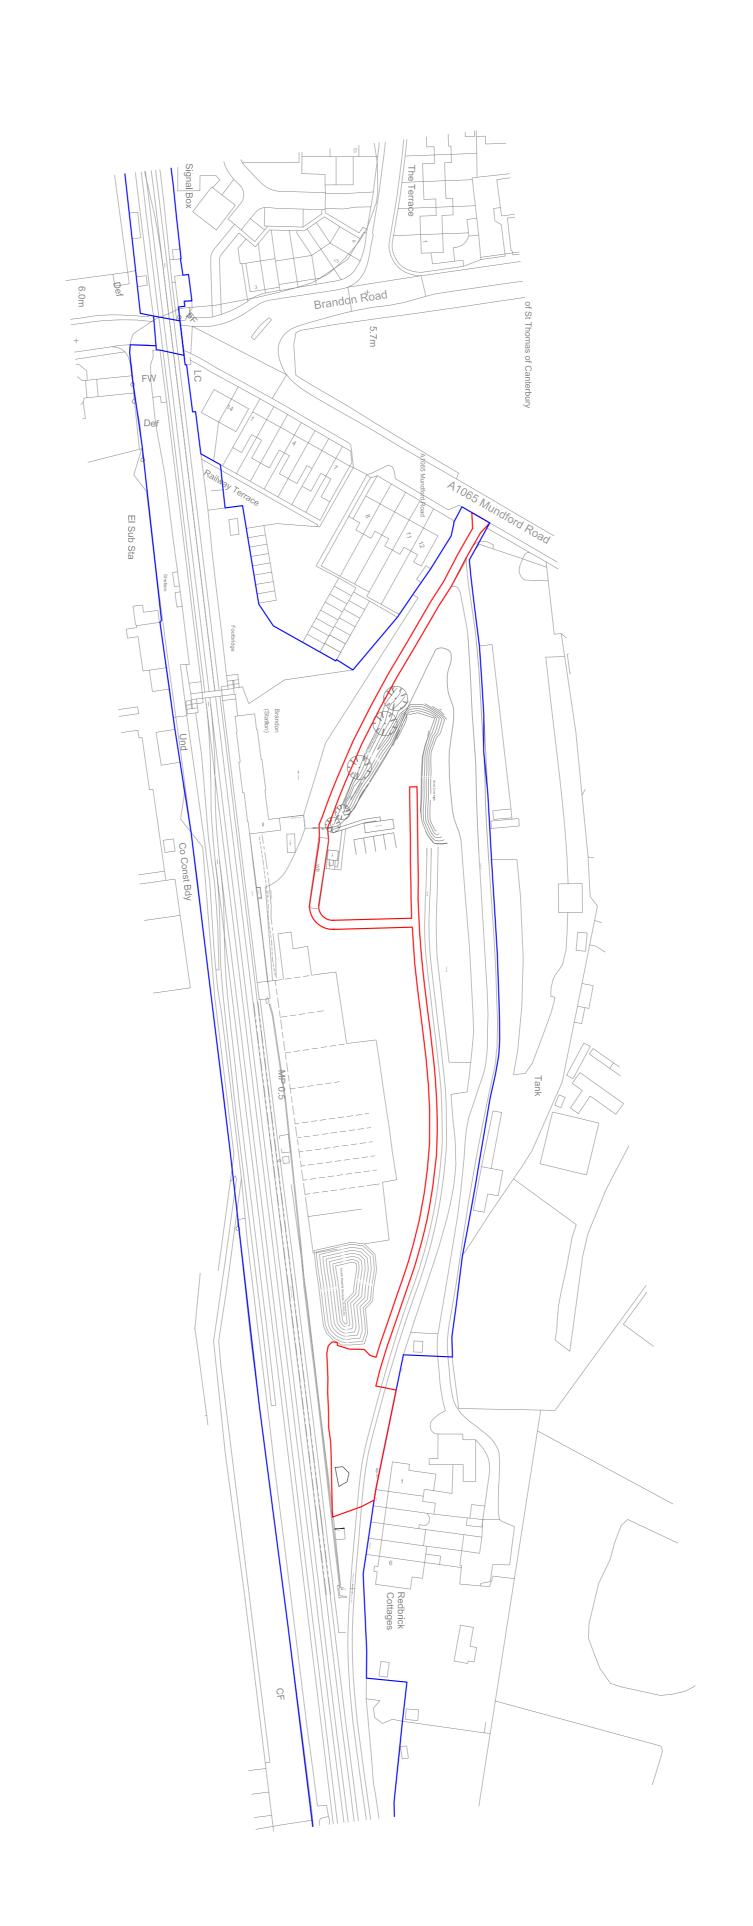

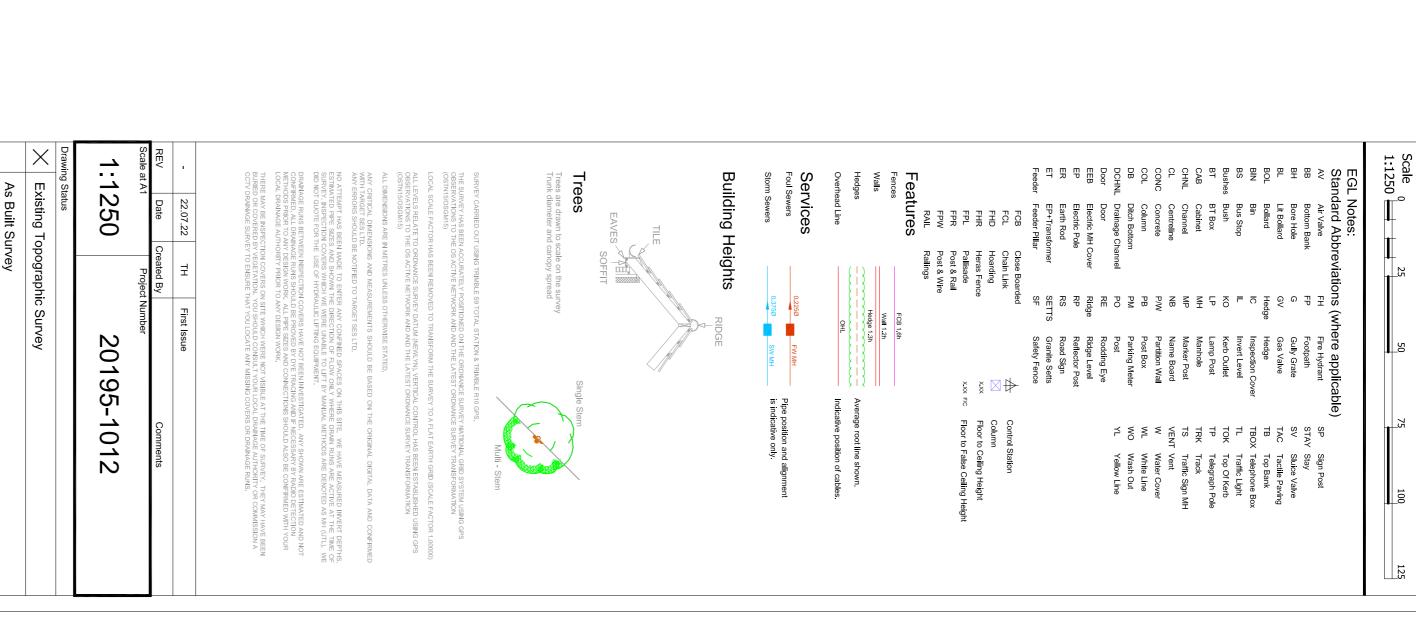

For Information	As Built Survey

2 Flint Cottages, Lackford, Bury St Edmunds, Suffolk, IP28 6HW t: 01284 711476 m: 07557 734388 e: info@targetltd.co.uk

Brandon Rail Head

Network Rail

File Path:D:\Dropbox\Dropbox\Target 2022\Target Jobs 2022\Huckstep\Brandon\Retrospective Planning July 2022\TSES-20195-1012-EGL-01.dwg

Site Location Plan (Retrospective)

TSES- 20195- 1012- DSN- 01